



NOTES
THIS DRAWING IS COPYRIGHT AND MUST NOT BE REPRODUCED WITHOUT PERMISSION




POWDER COATED ALUMINIUM FRAMED DOUBLE GLAZED WINDOWS AND DOUBLE SWING ENTRANCE DOORS WITH STRAIGHT PULL HANDLES AND LETTERPLATE, FRAMING COLOUR DARK BLUE RAL 5003, GREY TINTED ANTI-SUN GLAZING. SURROUNDING FLASHINGS IN SARGASSO BLUE RAL 5003 TO MATCH.

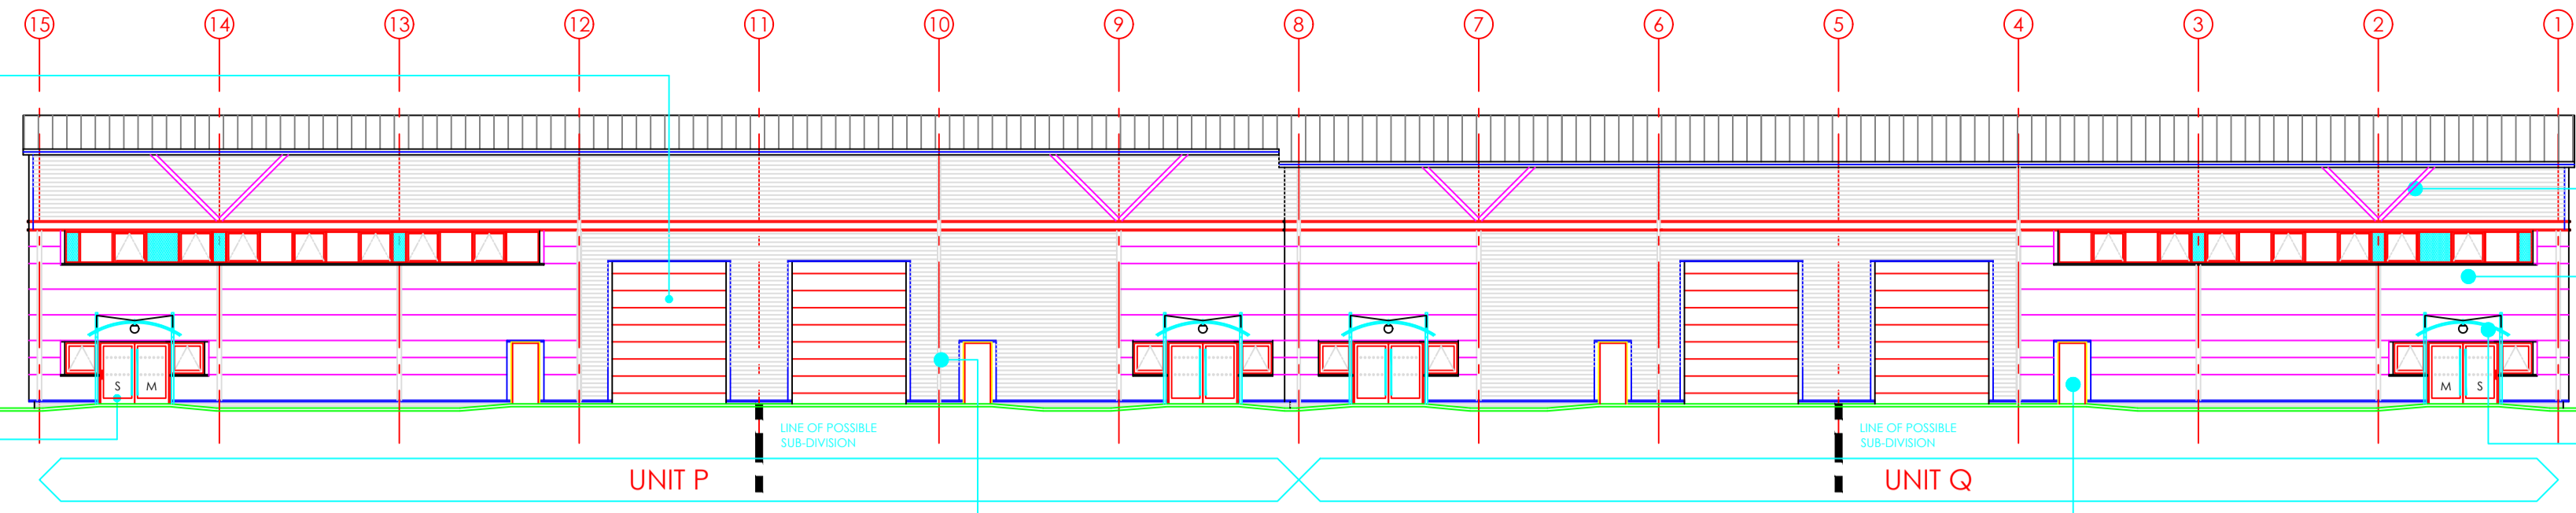


NORTH ELEVATION TO SERVICE AREA

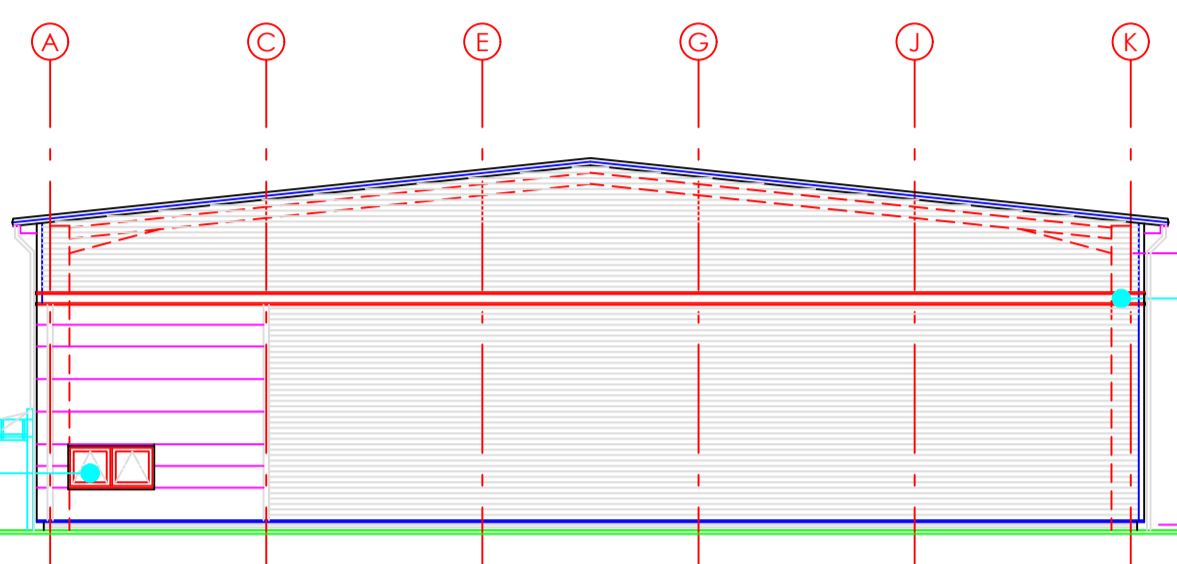


WEST ELEVATION

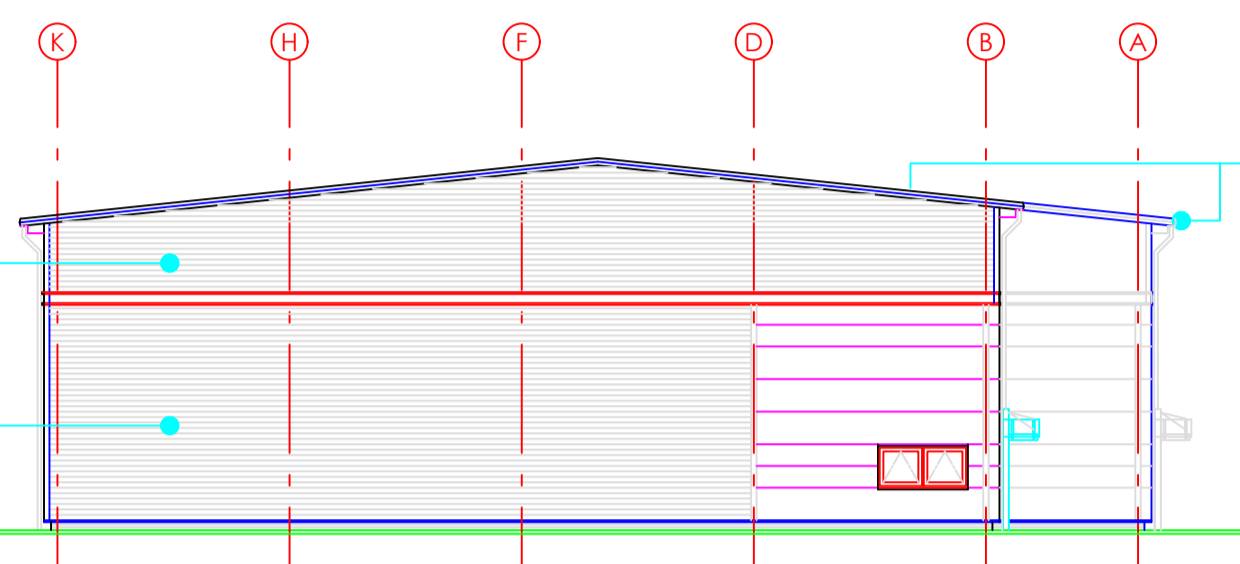

EAST ELEVATION - BOUNDARY FIREWALL

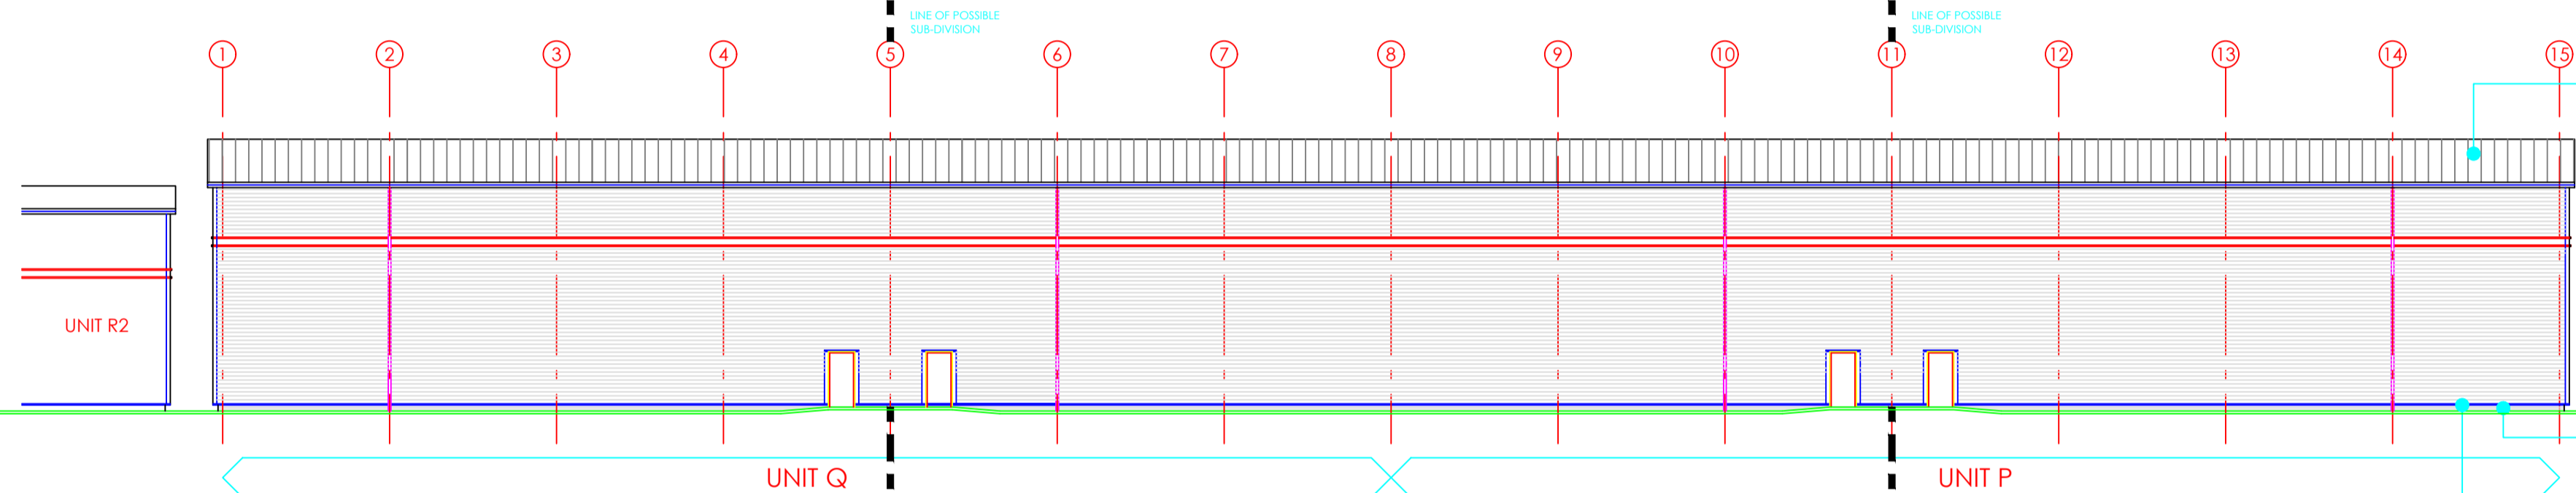

SOUTH ELEVATION TO RAILWAY LINE - BOUNDARY FIREWALL

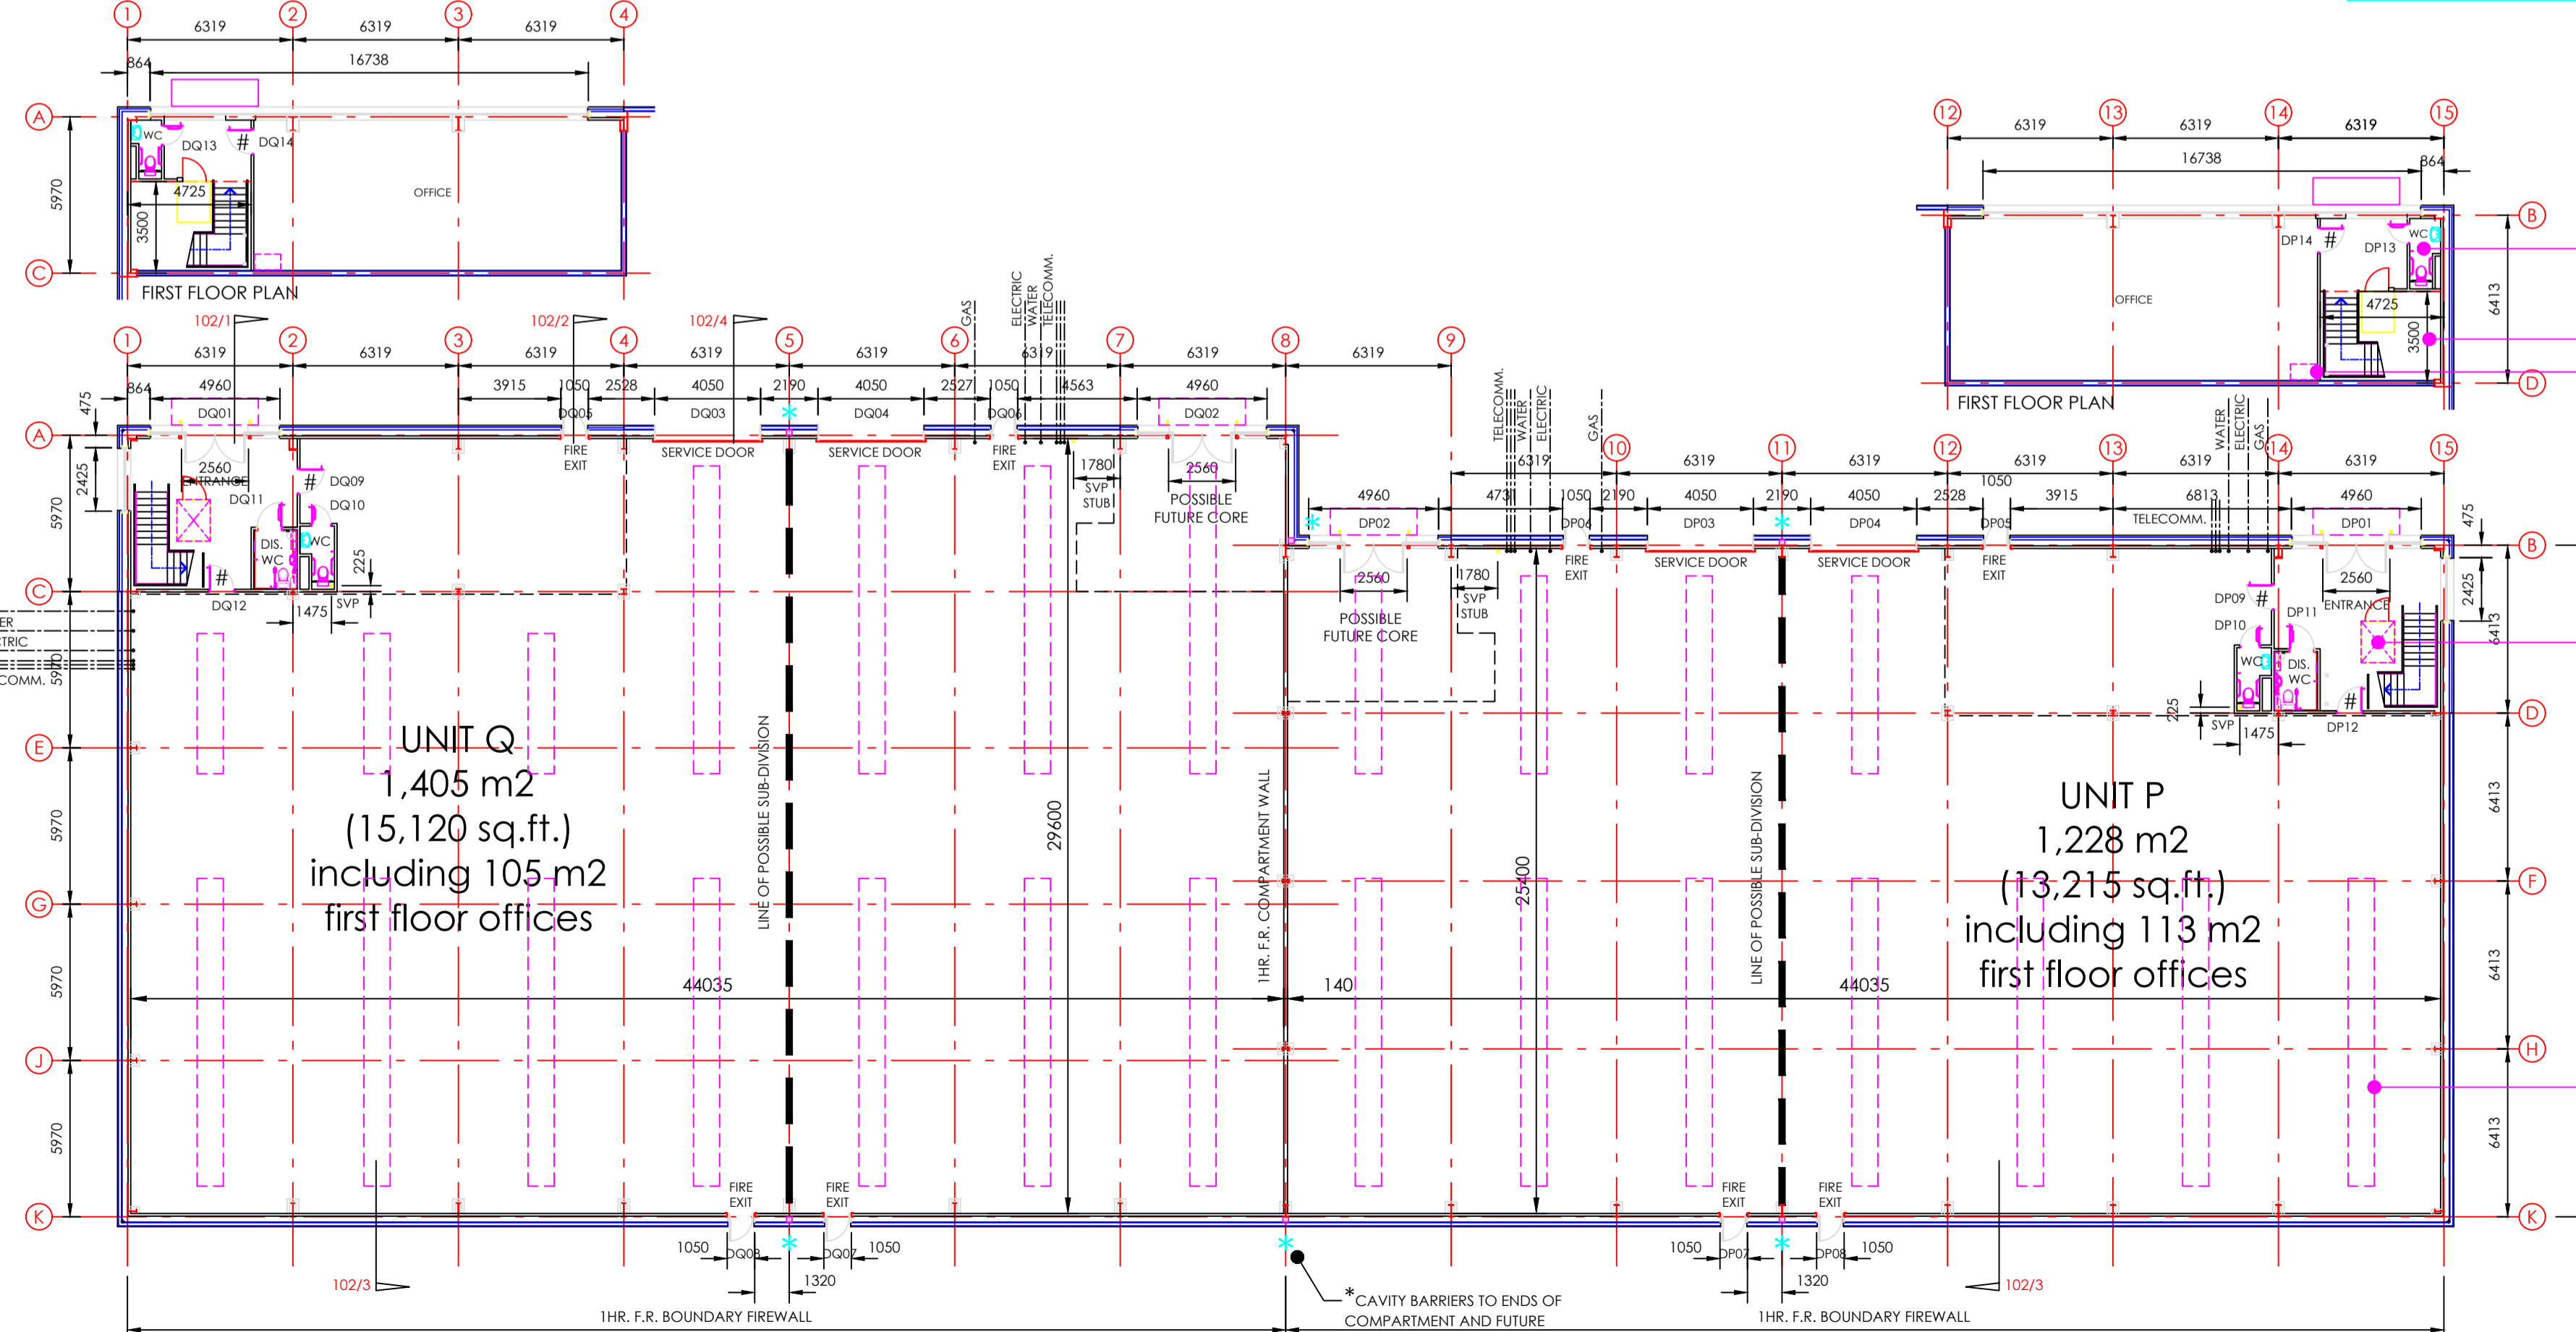

FLOOR PLANS

PLASTISOL COATED PRESSED METAL ROOF SHEETING. COLOUR MUSHROOM BS 10B19. EVENLY SPACED TRANSLUCENT GRP ROOFLIGHTS OF AREA APPROX. 10% OF FLOOR AREA.

UNIT N (EXG. PHASE 2)

FACING BRICKWORK PUNTH. IN BAGGERIDGE BARKHAN BUFF DRAG FACED BRICKS WITH NATURAL COLOURED MORTAR JOINTS. MATCHING COLOURED MOVEMENT JOINT SEALANT.

FEATURE DRIP FLASHING IN SARGASSO BLUE RAL 5003 TO FOOT OF WALL CLADDING.

WC CUBICLES AT GROUND AND FIRST FLOOR LEVEL TO AMBULANT DISABLED USE REQUIREMENTS. ACOUSTIC INSULATION INSTALLED OVER CEILINGS.

STAIRWELL DIMS TO EDGE OF FLOOR SLAB

FACILITIES FOR FUTURE KITCHEN SINK

COMPARTMENT WALLS AND SEPARATING WALLS TO BE FIRE STOPPED AT UNDERSIDE OF STRUCTURE WITH DEFLECTION HEAD DETAIL TO ALLOW MOVEMENT AS SPECIFIED BY CONSULTING ENGINEER

FIRE DOORS TO FD30S

ENCLOSED DISABLED PLATFORM LIFT, 400KG RATED LOAD. SET IN 1280x1590x60MM DP PIT. SHAFT HEIGHT 6700MM. STEEL STAIRCASE WITH STAINLESS STEEL HANDRAIL, BALLUSTRADES AND INFILL BARS.

BOTH ABOVE TO MEET REQUIREMENTS OF BUILDING REGS. PART M

ROOF LIGHTS WILL BE FACTORY ASSEMBLED. TRIPLE SKIN. SAB CLASS 3 OUTER AND SA CLASS 1 LINER PANELS. EQUIVALENT IN AREA TO APPROXIMATELY 10% OF FLOOR AREA AND WILL COMPLY WITH CURRENT HEALTH & SAFETY LEGISLATION. ROOFLIGHTS TO START AND FINISH APPROX. 2M FROM RIDGE AND EAVES.

AS BUILT

E	AS BUILT ISSUE.	25.11.07	DW
D	INCOMING SERVICE LOCATIONS ADDED. FUTURE CORE SVP STUBS AMENDED.	4.4.07	DW
C	STEEL SECTIONS AND FOUL DRAINAGE ADDED.	8.3.07	DW
B	GRID AND STEELWORK DIMENSIONS ADDED. CONSTRUCTION ISSUE.	8.2.07	DW
A	TENDER ISSUE	7.3.06	DW
Rev			Date Initial

The Round Foundry
105 Water Lane
Leeds
LS11 5WD
Telephone 0113 388 4330
Facsimile 0113 388 4340

SMC Gower Architects
Moorfields
London W1K 4LR
Telephone 020 7355 3001
Facsimile 020 7491 7093
london@smcgower.com
www.smcgower.com

Client
SCHRODER EXEMPT PROPERTY UNIT TRUST

Project
ACORN INDUSTRIAL PARK CRAYFORD - PHASE 3

Drawing description
FLOOR PLANS AND ELEVATIONS UNITS P & Q

Drawing number
A3419 / AL(00)100

A	B	C	D	E					
Scale	1:200 @ A1				Drawn	DW			
Date	JAN 2006				Checked				