


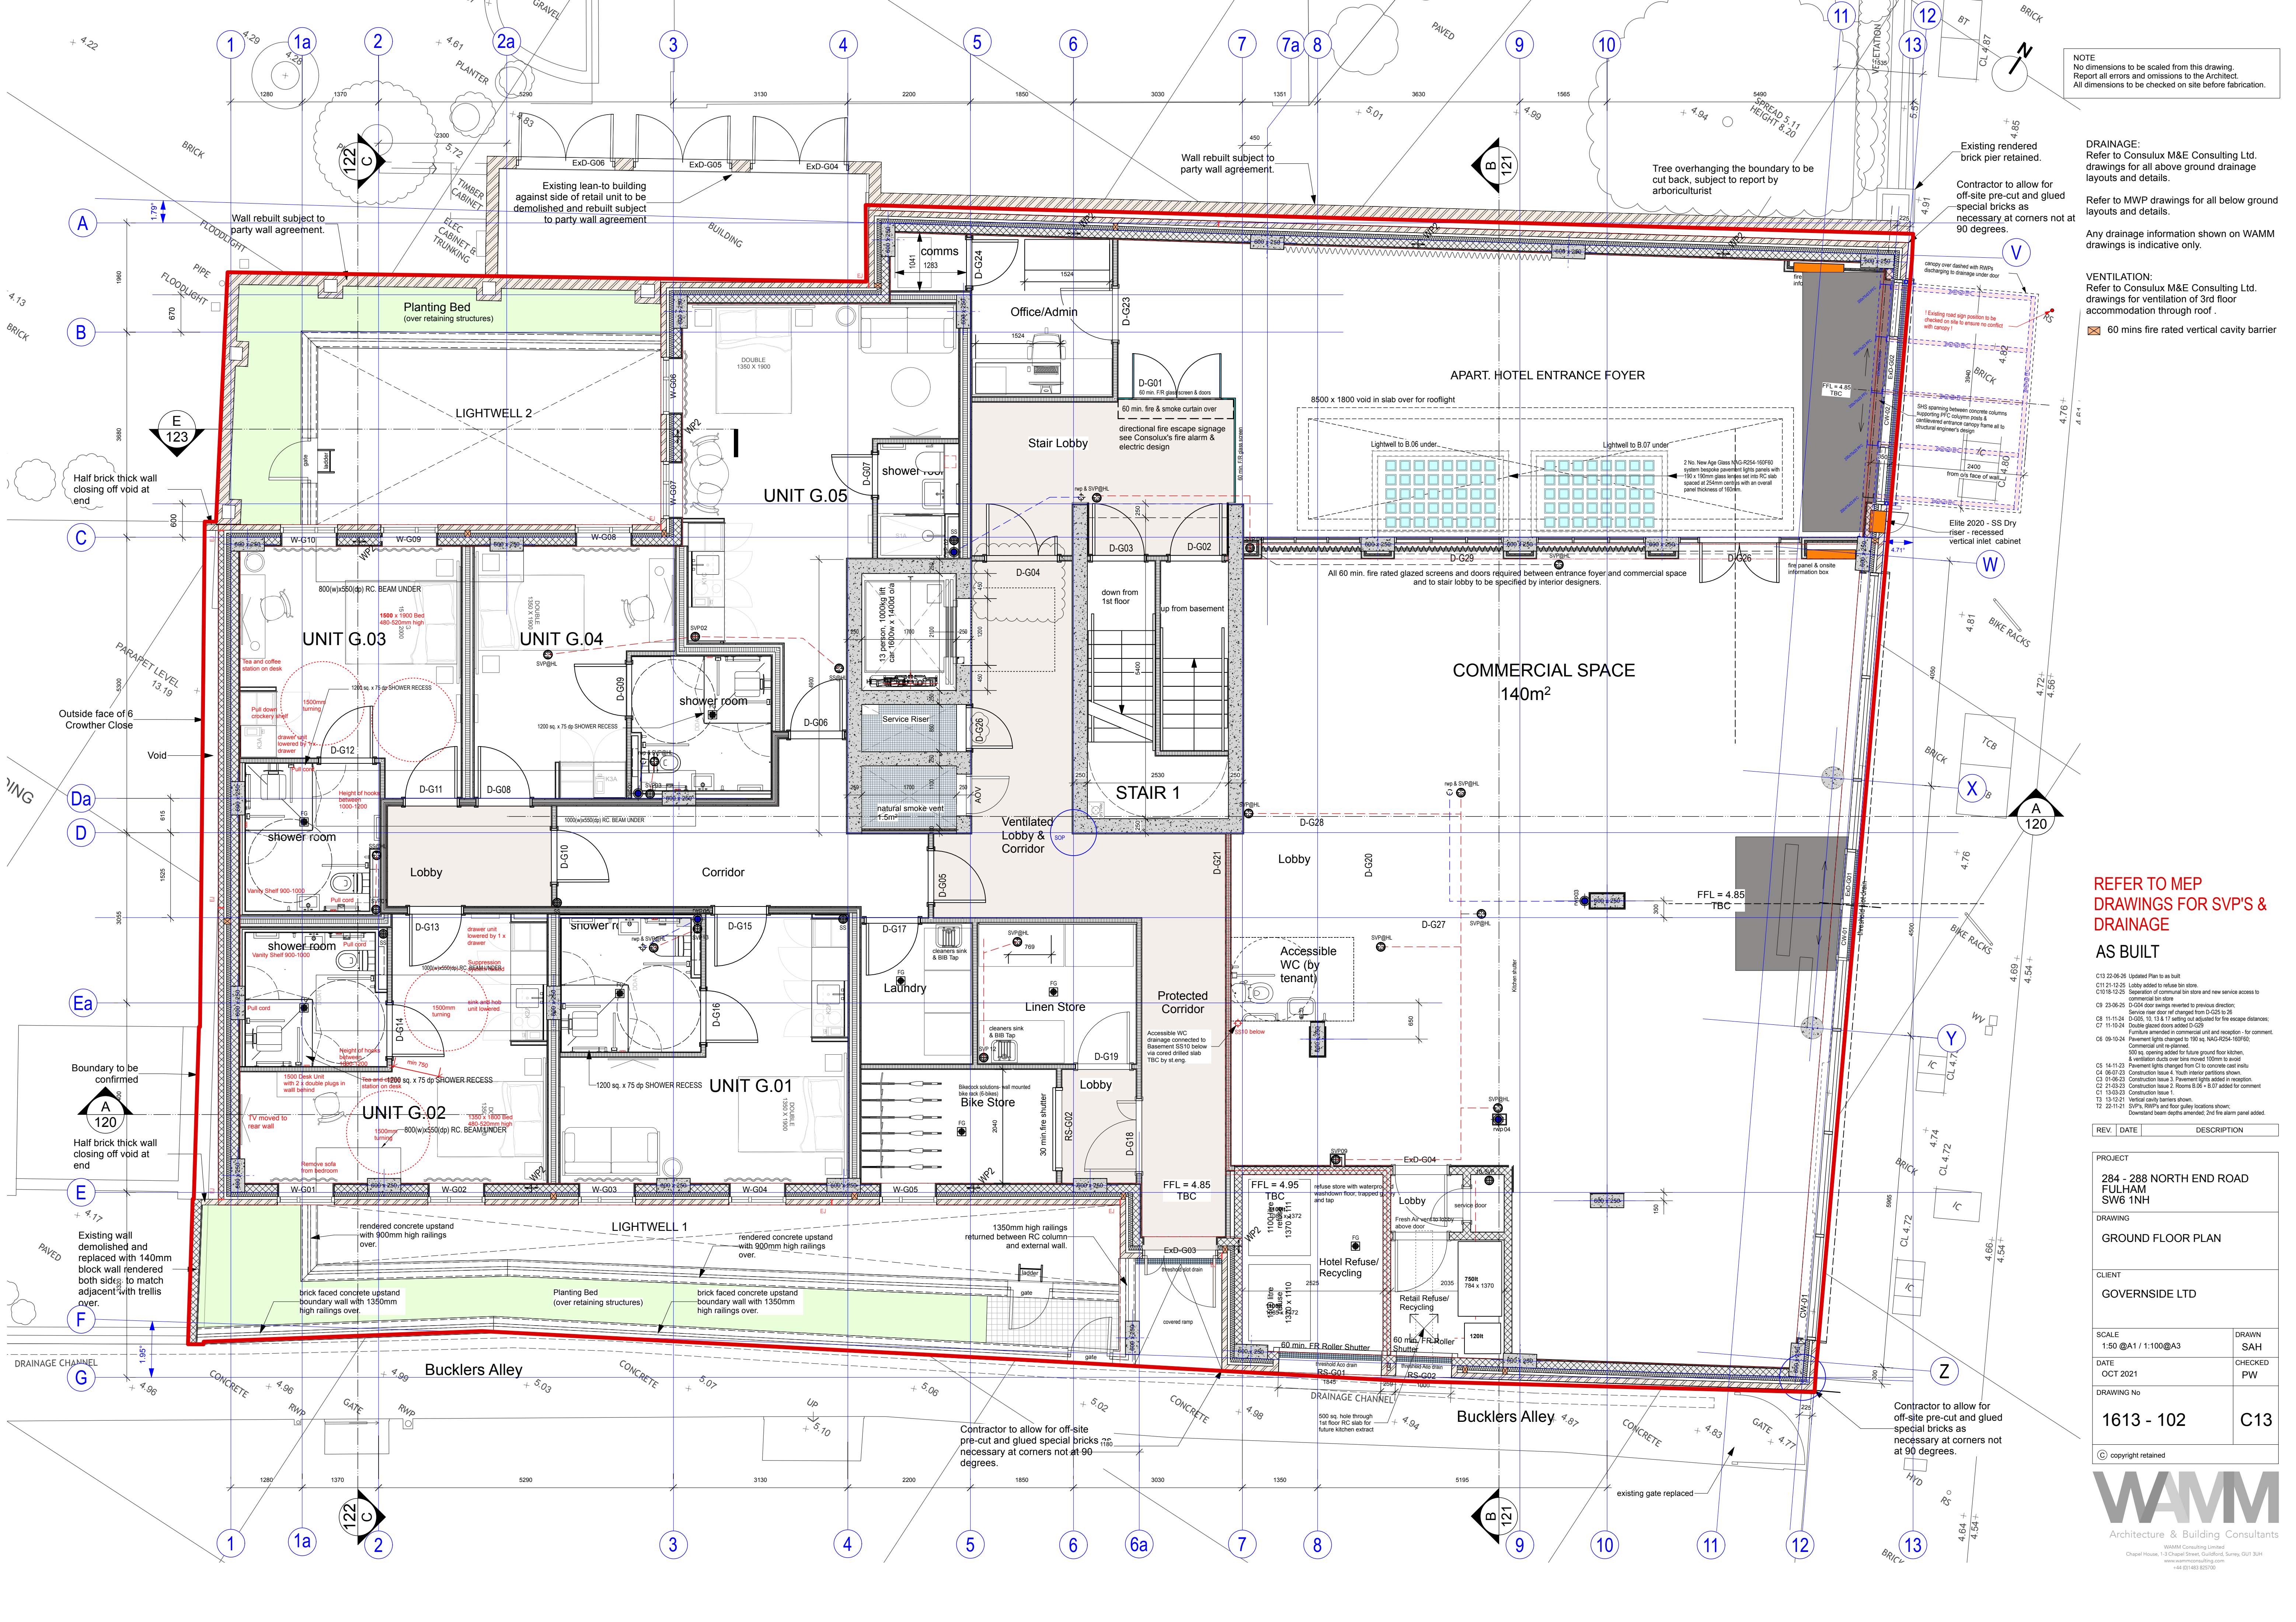

REFER TO MEP
DRAWINGS FOR SVP'S &
DRAINAGE
AS BUILT

C10 22-05-26 Updated Plan to as built
C11 21-12-25 Lobby added to release bin store
C10 18-12-25 Separation of communal bin store and new service access to commercial unit
C9 23-06-25 D-G04 door swings reversed to previous direction
C8 11-11-24 D-G05, 10, 13 & 17 setting out adjusted for fire escape distances
C7 11-10-24 Double glazed doors added D-G29
C6 09-10-24 Furniture arranged in commercial unit and reception - for comment
C5 14-11-23 Pavement lights changed from C1 to concrete cast in situ
C4 06-07-23 Construction Issue 4: Youth centre partitions shown
C3 01-06-23 Construction Issue 3: Pavement lights added in reception
C2 21-03-23 Construction Issue 2: Rooms 5.06 & 5.07 added for comment
C1 13-03-23 Construction Issue 1
13 15-12-21 Vertical cavity barriers shown
12 22-11-21 SVPs, RWP's and floor gully locations shown
Downward beam depths amended, 2nd fire alarm panel added.

REV.	DATE	DESCRIPTION
1	2021	As Built

PROJECT	284 - 288 NORTH END ROAD FULHAM SW6 1NH
DRAWING	GROUND FLOOR PLAN
CLIENT	GOVERNSIDE LTD
SCALE	1:50 @A1 / 1:100 @A3
DATE	OCT 2021
DRAWING No	1613 - 102
DRAWN	SAH
CHECKED	PW
© copyright retained	C13