

SUSAN STOUT, ARCHITECT
6655 AUTUMN OAKS DR.
OLIVE BRANCH, MS 38654
901.598.2321
sstoutarch@yahoo.com
SUSAN STOUT, AIA

AS BUILT FLOOR PLAN FOR:
GROVE OFFICE PARK
5740 GETWELL ROAD
BUILDING 6
SOUTHAVEN, MISSISSIPPI

AS BUILT
FLOOR PLAN


Client:
Chuck Roberts

Project Number:	20049
-----------------	-------

Date: July 21, 2025

Revisions		

A1.1

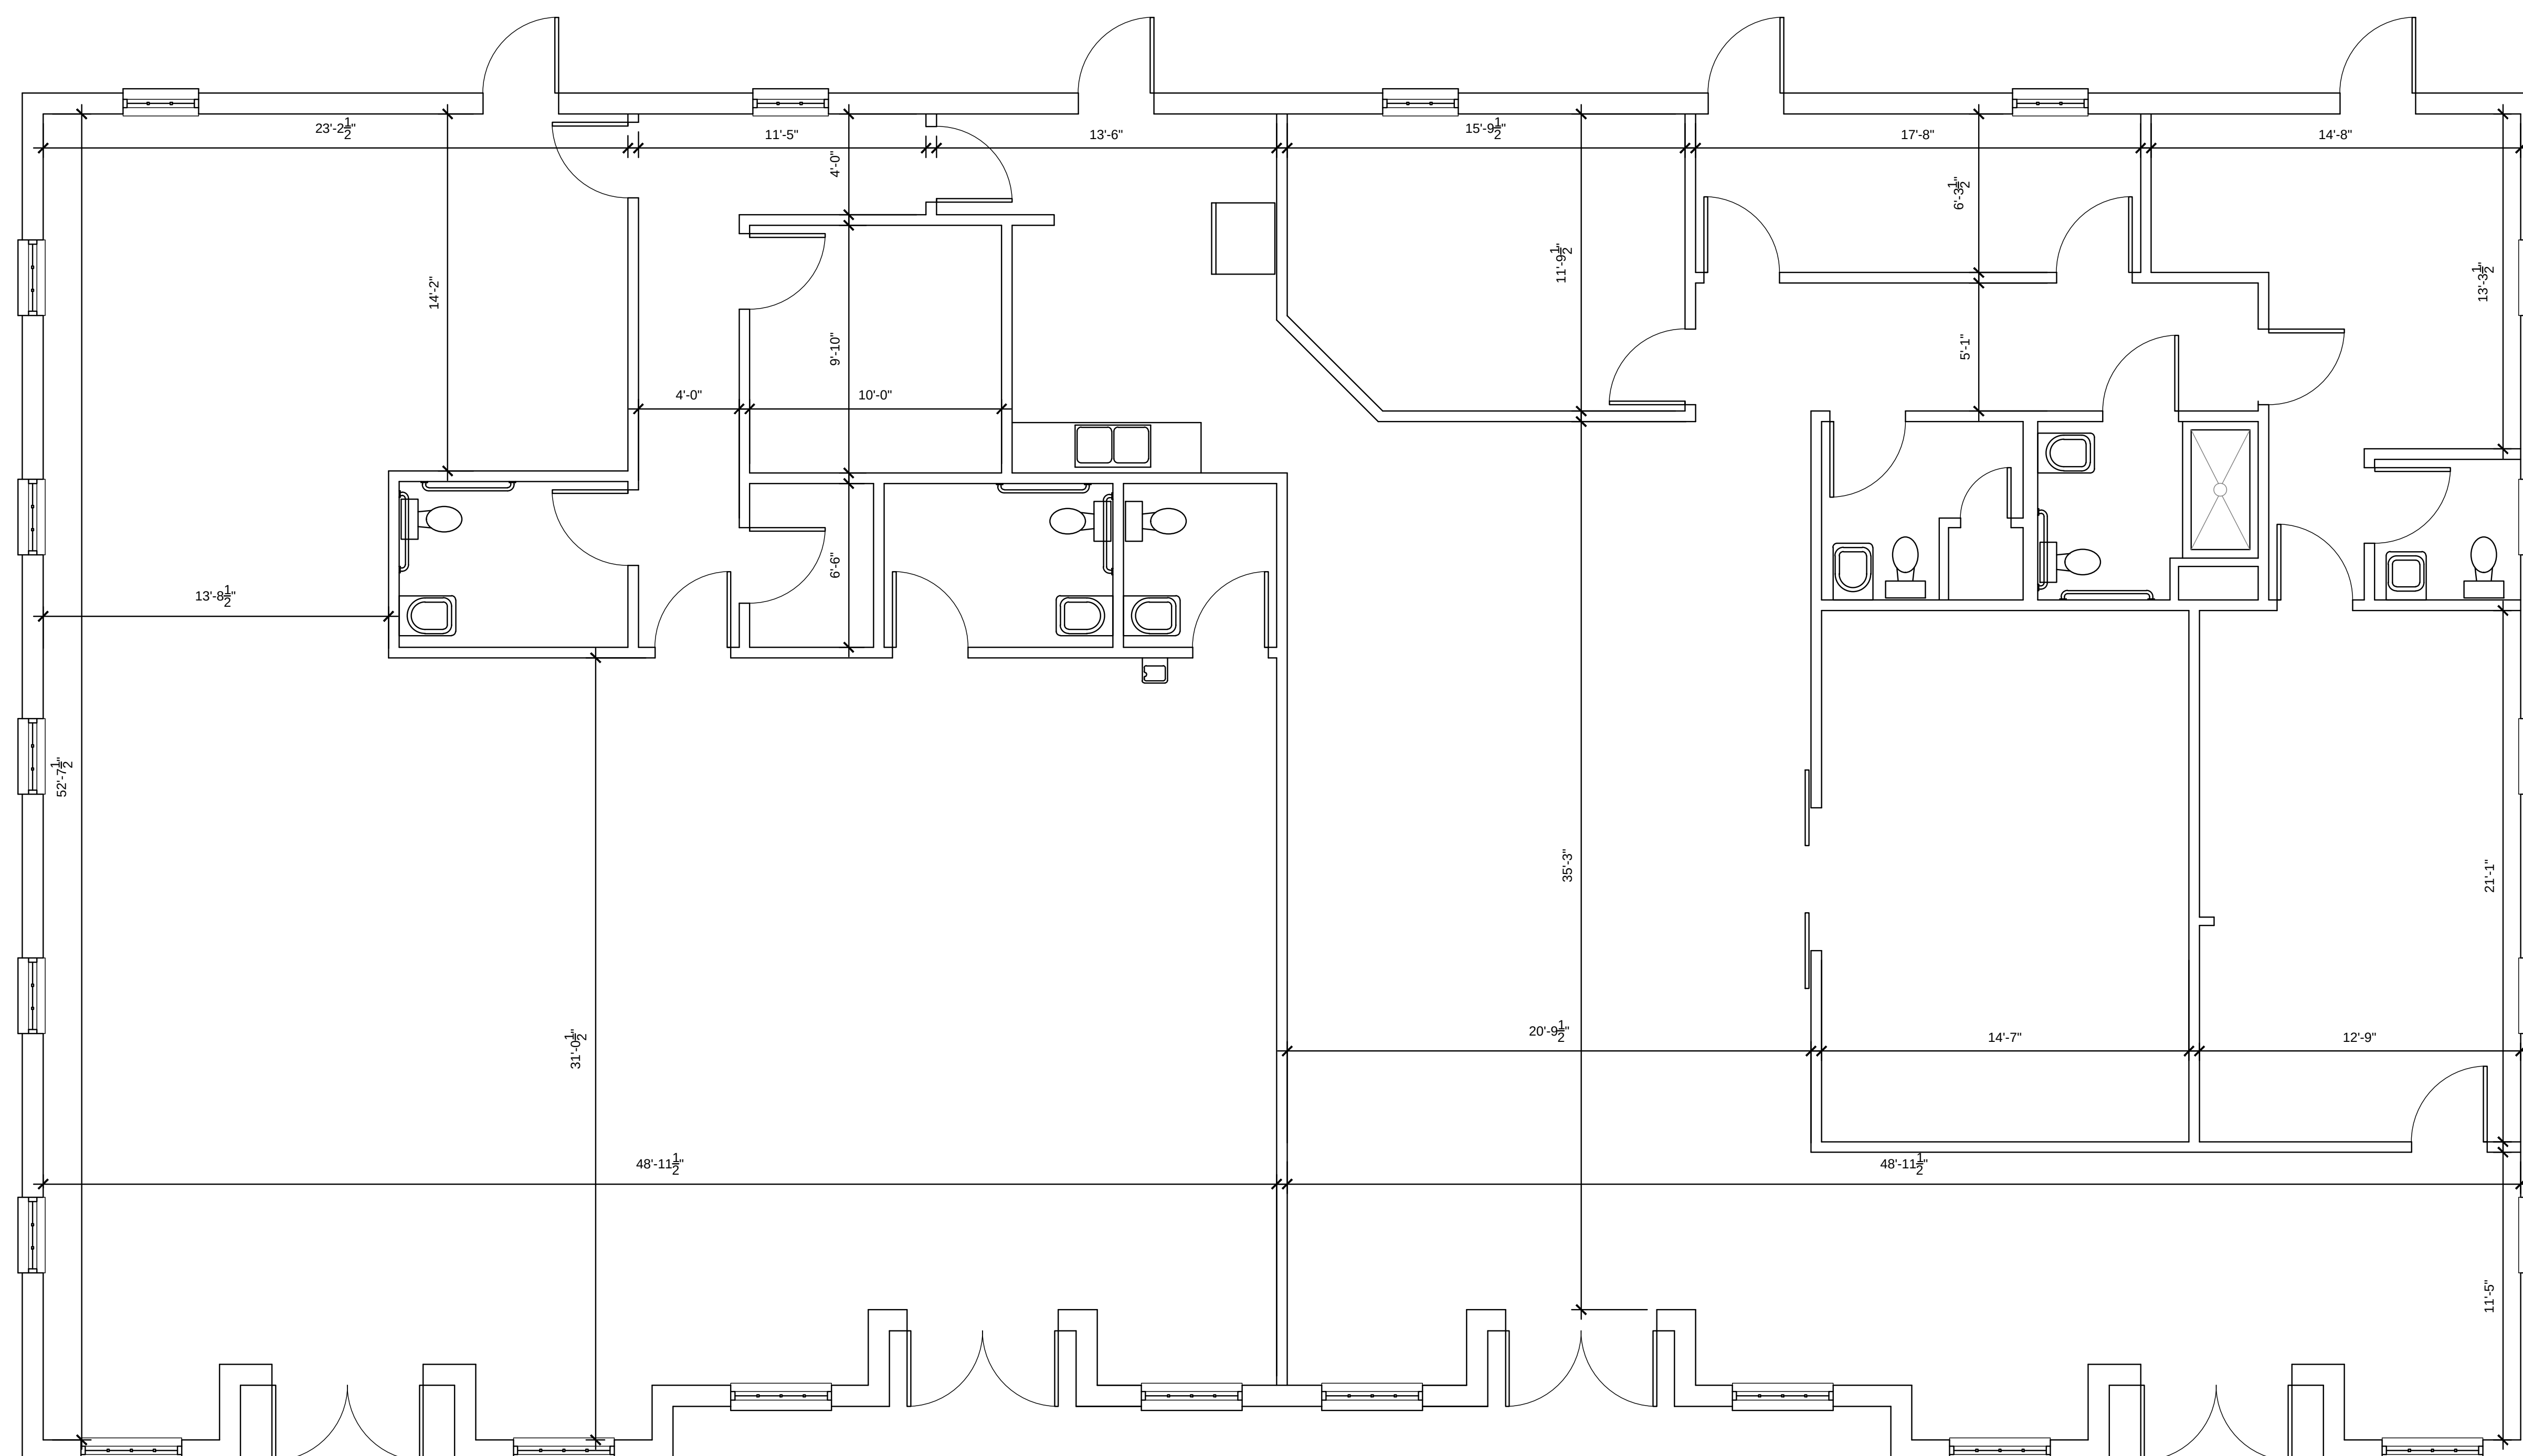

1 AS BUILT FLOOR PLAN
SCALE: 1/4"=1'-0"