

Notes


Do not scale from this drawing, except for planning purposes. Figured dimensions only are to be taken from this drawing. All dimensions to be checked on site. Any discrepancies are to be reported to the Contract Administrator prior to works or fabrication.

This drawing is to be read in conjunction with all relevant consultants and/or specialists' drawings/documents and any discrepancies or variations are to be notified to the Contract Administrator immediately.

This drawing is the property of HB Surveyors and Valuers. No reproduction without permission.

Revisions

Rev	Notes	Dwn	Date
-----	-------	-----	------

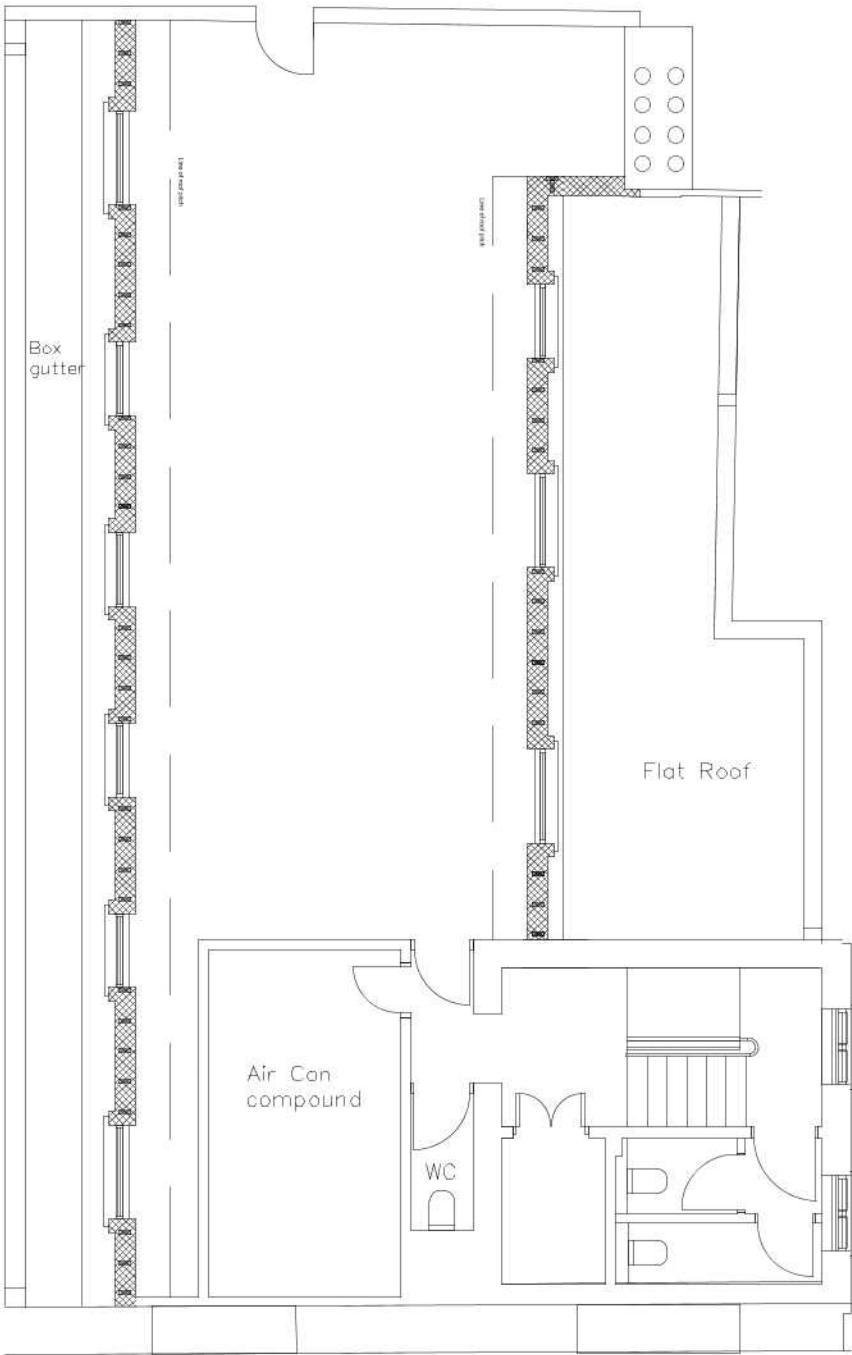

Client
Latitude
Project
Fifth Floor
33 Welbeck Street
Title
As built layout

Date	Scale:Paper	Drawn
24.07.19	1:100@A3	OT
Job Number	Drawing Number	
	100 rev.B	

Portland House
4 Great Portland Street
London W1W 8QJ
t: 020 7907 4500
f: 020 7907 4501

www.hbsv.com

