


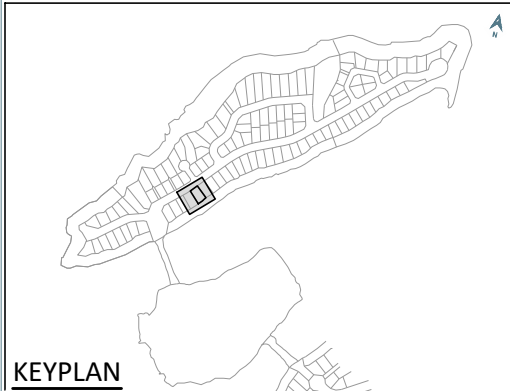

SCHEDULE OF AREAS		
LEGAL DESCRIPTION	RT	AREA
LOT 6 DP 577805	1087126	644m ²
	TOTAL	644m ²