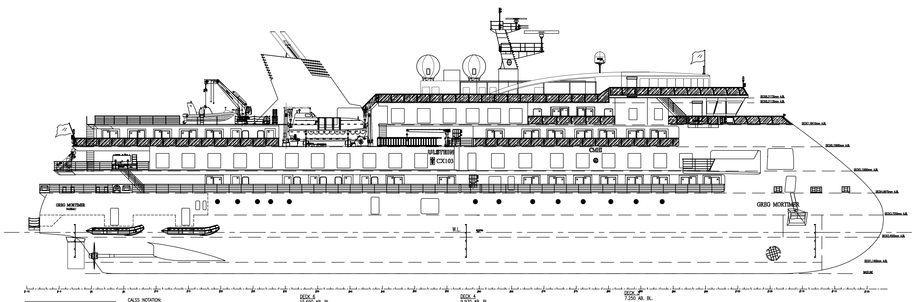

PRINCIPAL DIMENSIONS:

L.O.A.	104,4 m
LLL	100,2 m
BREADTH MOULDED:	18,4 m
DEPTH TO MAIN DECK:	7,25 m
DRAUGHT MAX.	5,3 m
DESIGN DRAUGHT	5,1 m

FRAME SPACING : 800 mm

ACCOMODATION CAPACITY

CREW	= 45
CREW EXPEDITION)	= 6
TOTAL	= 204

ALL DECKS
90 PAX CABINS (180)
57 CREW CABIN (94)

CLASS NOTATION:
Ice Passenger Ship, POLAR CAT-B, + HULL, +MNC,
RMK(ESD)RU(NCV, POI, ICE CLASS IA, Comf-Noise-Pax
1, Comf-Noise-Crew 3, CLEANSHIP, AUT-UMS,
MON-SHAFT, LHG-S2, SEEMP, Unrestricted navigation

DECK 2
18.410 Kb. BL.

PASSENGER CABIN TYPE	QTY	PERSON/ CABIN	TOTAL CAPACITY
SUITE WITH BALCONY TYPE 2	4	2	8
TOTAL	4		8
CREW CABIN TYPE	QTY	PERSON/ CABIN	TOTAL CAPACITY
CAPTAIN CABIN	1	1	1
CHIEF ENG.CABIN	1	1	1
TOTAL	2		2

DECK 3
15.690 Kb. BL.

PASSENGER CABIN TYPE	QTY	PERSON/ CABIN	TOTAL CAPACITY
SUITE WITH BALCONY TYPE 7	12	2	24
SUITE WITH BALCONY TYPE 8	11	2	22
SUITE WITH BALCONY TYPE 9	2	2	4
SUITE WITH BALCONY TYPE 10	2	2	4
SUITE WITH BALCONY TYPE 11	2	2	4
TOTAL	29		58
CREW CABIN TYPE	QTY	PERSON/ CABIN	TOTAL CAPACITY
1 CREW CABIN	4	1	4
NON TYPE 1 CREW CABIN	1	1	1
1 CREW OFFICER CABIN	1	1	1
TOTAL	10		10

DECK 4
9.970 Kb. BL.

PASSENGER CABIN TYPE	QTY	PERSON/ CABIN	TOTAL CAPACITY
SUITE WITH BALCONY TYPE 1	1	2	2
SUITE WITH BALCONY TYPE 3	1	2	2
SUITE WITH BALCONY TYPE 4	1	2	2
SUITE WITH WINDOW TYPE 5	1	2	2
SUITE WITH BALCONY TYPE 6	1	2	2
SUITE WITH BALCONY TYPE 7	22	2	44
SUITE WITH BALCONY TYPE 8	4	2	8
SUITE WITH BALCONY TYPE 9	1	2	2
SUITE WITH BALCONY TYPE 11	1	2	2
TOTAL	33		66

DECK 5
7.200 Kb. BL.

PASSENGER CABIN TYPE	QTY	PERSON/ CABIN	TOTAL CAPACITY
SUITE WITH WINDOW TYPE 5	14	2	28
TOTAL	14		28
CREW CABIN TYPE	QTY	PERSON/ CABIN	TOTAL CAPACITY
1 CREW CABIN	6	1	6
2 CREW CABIN	1	2	2
DOCTOR'S CABIN	1	1	1
GIGA-BAY	1	1	1
EXP. MAN. CABIN	1	1	1
2 EXPD CABIN	4	2	8
TOTAL	13		18

DECK 2
4500 Kb. BL.

CREW CABIN TYPE	QTY	PERSON/ CABIN	TOTAL CAPACITY
2 CREW CABIN	32	2	64
TOTAL	32		64

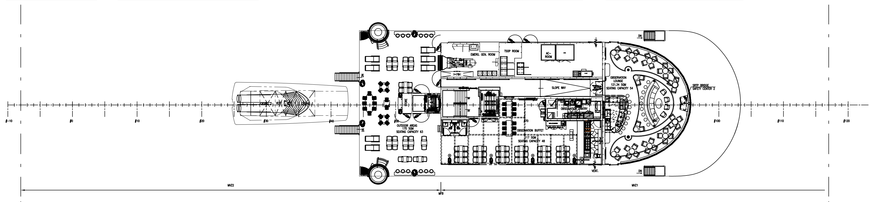

NOTES:
1. ARRANGEMENT OF EQUIPMENTS IN CABIN AND E/A ETC. IS FOR REFERENCE ONLY. FOR EXACT POSITION AND SIZE TO BE SHOWN IN RELATED PLANS.
2. EXACT POSITION OF BULKHEADS AND OTHER STRUCTURES TO BE SHOWN IN RELATED STRUCTURE PLANS WHERE THERE ARE NO DIMENSION IN THIS PLAN.
3. EQUIPMENTS AND STRUCTURES NOT SHOWN IN THE PLAN TO BE SHOWN IN RELATED PLANS.
4. ALL WORKS SHALL BE CARRIED OUT ACCORDING TO 0T1038-101-100-01_F GENERAL ARRANGEMENT.

BELOW
MAIN DK

APPROVED BY:
OWNER DATE
CLASS DATE
BUILDER DATE

THIS DRAWING AND ALL INFORMATION CONTAINED HEREIN IS PROPRIETARY AND CONFIDENTIAL AND IS THE EXCLUSIVE PROPERTY OF SUNSTONE SHIPS, INC. AND SHALL NOT BE DISCLOSED TO ANY THIRD PARTY WITHOUT THE PRIOR WRITTEN CONSENT OF SUNSTONE SHIPS, INC. 

CONFIDENTIAL
RESTRICTION LEVEL
SUB | BASIC | GA

REFERENCE DRAWING

No.	TITLE	PLAN No.
1	GENERAL ARRANGEMENT	0T1038-101-100-01-F
2	TANK PLAN	0T1038-130-100-01-F

REVISIONS

MARK	No.	DESCRIPTION	DATE	DRAWN

SUNSTONE SHIPS, INC.			
CHINA MERCHANTS HEAVY INDUSTRY (JIANGSU) CO.,LTD.			
No.3 Liuhong Road, Economic&Technical Development Zone, Nantong, Jiangsu, P.R.C. P.C.:226010 Tel: 0086-513-85871888 Fax: 0086-513-85871889			
M/V GREG MORTIMER			
GENERAL ARRANGEMENT			
DRAWN	RSB	20/08/21	
CHK'D	RSB	20/08/21	
APP'D			
DWG No.	CMHB-196-1		
STATUS	AS BUILT		
SCALE	1:250		
SHT. SIZE	ARCH D		
SHT. No.	1 OF 1 SHTS		
REV.	2		
DATE	20/08/21		
FILE No.	CMHB-196-1-GA-REV2.DWG		