




# PLANTERLINE

## TECHNICAL DATA SHEET

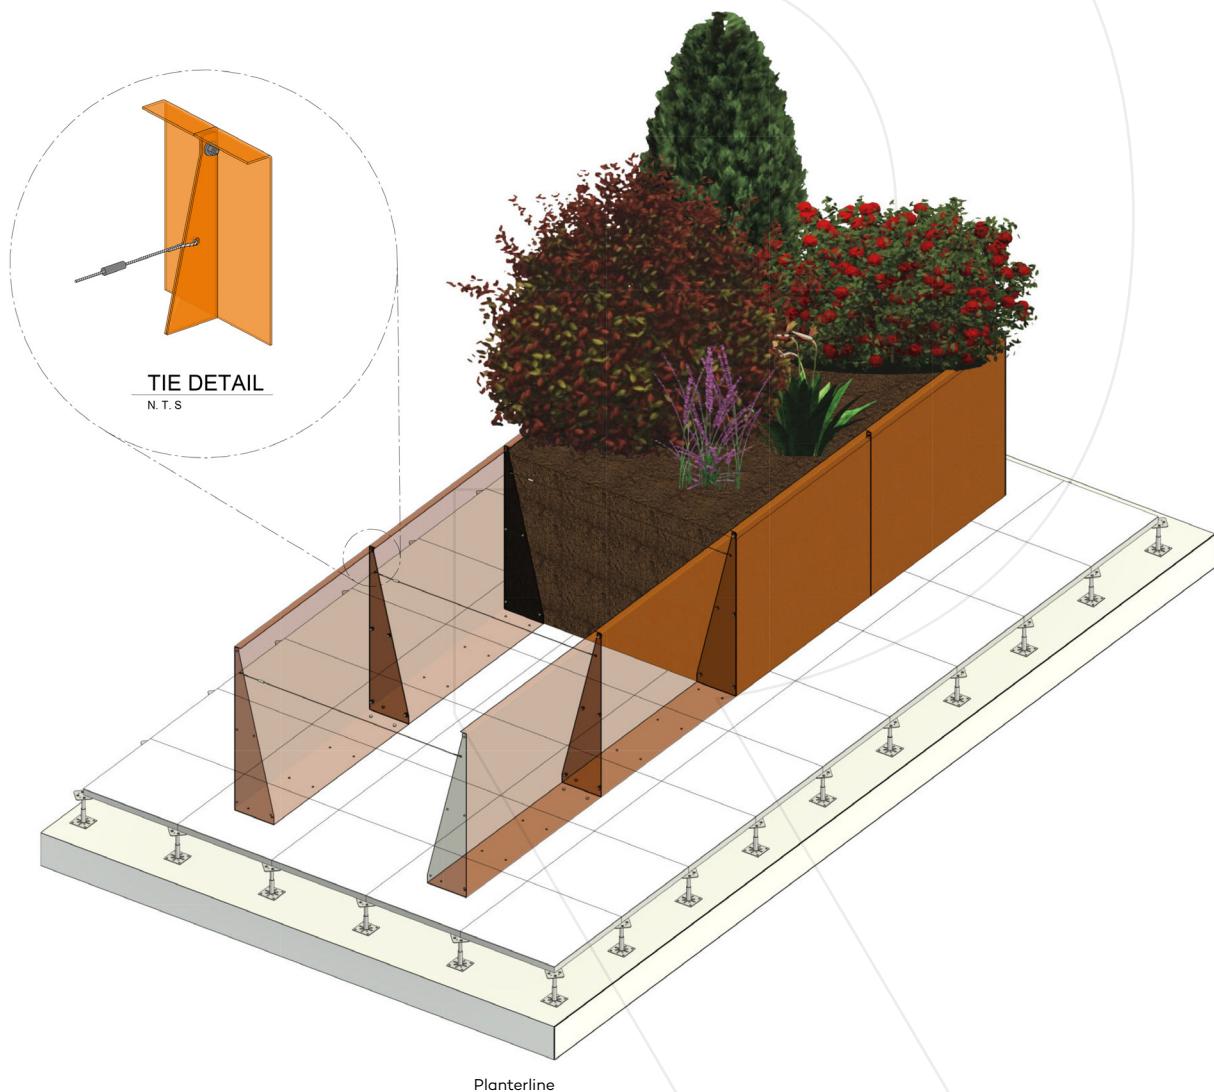

**Find out more or request a sample**

Email [hello@raafsystems.com](mailto:hello@raafsystems.com) or visit [raafsystems.com](http://raafsystems.com)

© 2025 Raaft® Ltd. At the time of writing and publication of the sheet, all information is specified correctly. The company reserves the right to change the specifications of this product at any time without prior notice to third parties. Any images and diagrams used in this sheet are intended only as illustrations. No rights can be derived from them.

Ref: DS-PP-0323 Last update: December 2025

# PLANTERLINE

## TECHNICAL DATA SHEET

### Planterline

PRODUCT NAME	COLOR	DIMENSIONS		OTHER	
Planterline Planterline Custom	Powder coated	Maximum straight panel length	2400mm (94.49 in)	Material specification	Corten A steel materials class A EN10029
		Maximum returns at corners	1000mm (39.37 in) Limited to one side		
	Corten	Height Range	300-1100mm (11.81-43.31 in)	Corner types	Folded
		Steel thickness	3mm (0.12 in)		
				Top return	40mm (1.57 in) single top

### Loading analysis

PLANTER HEIGHT	PANEL DEFLECTION	WET SOIL LOAD PER M <sup>2</sup>
300mm (11.8 in)	0.02mm	300H - 510kg (1,124 lbs) 400H - 680kg (1,499 lbs)
600mm (23.6 in)	0.14mm	500H - 850kg (1,874 lbs) 600H - 1,020kg (2,249 lbs) 700H - 1,190kg (2,623 lbs)
900mm (35.4 in)	0.66mm	800H - 1,360kg (2,998 lbs) 900H - 1,530kg (3,373 lbs)
1100mm (43.3 in)	1.1mm	1,000H - 1,700kg (3,748 lbs) 1,100H - 1,870kg (4,122 lbs)

Structural calculations for our Planterline planters have been completed to ensure they are fit for standard use. Based on the calculations made, a deflection amount was measured on four planter heights as per the above.

Please note this information should be used as a guide only. Please contact us if you would like further information on the structural calculations made.

### Standard Planterline planters only

PLANTER HEIGHT	WEIGHT PER LM
300mm (11.8 in)	28.66 lbs
400mm (15.8 in)	35.27 lbs
470mm (18.5 in)	39.68 lbs
500mm (19.7 in)	42.89 lbs
600mm (23.6 in)	54.01 lbs
700mm (27.6 in)	60.63 lbs
800mm (31.5 in)	67.24 lbs
900mm (35.4 in)	85.98 lbs
1000mm (39.4 in)	94.80 lbs
1100mm (43.3 in)	101.41 lbs

These weights are for standard Planterline planters only and anything custom would need to be discussed with technical team.

### Find out more or request a sample

Email [hello@raafsystems.com](mailto:hello@raafsystems.com) or visit [raafsystems.com](http://raafsystems.com)

# PLANTERLINE STRAIGHT

## INSTALLATION GUIDE



**SECTION THROUGH TYPICAL PLANTER ON RAISED ACCESS**  
1:18

**PLANTERS ON RAISED ACCESS WITH TIES**  
N.T.S.

**TYPICAL PLANTER SECTION**  
1:5

**DESIGN CRITERIA**

THIS PLANTER SYSTEM HAS BEEN DESIGNED TO COMBINE LOADINGS IN ACCORDANCE WITH BS EN 1997-1-1 FOR THE FOLLOWING CRITERIA:

MAX SURCHARGE LOADING ON TOP OF PLANTER = 0.75kN/m<sup>2</sup>  
ASSUMED WATER TABLE LEVEL + HEIGHT OF PLANTER = 0.75m  
REINFORCED CONCRETE BULK DENSITY = 24kN/m<sup>3</sup>  
ANGLE OF SHEAR = 45° + 20° = 65°  
PLANTER SYSTEM IS GRADE 430 3mm THICK GRADE 5075 CORROSION-RESISTANT STEEL  
CENTERS OF FINNS PROVIDED ARE CALCULATED BY THE MANUFACTURER AS 2.0m, LESS  
CENTERS OF FINNS PROVIDED ARE TO BE ADDED WHICH ARE BASED UPON MANUFACTURER'S RECOMMENDATION FOLLOWING AS-BUILT MEASUREMENTS.

COMPETENT SUB-STRUCTURE  
SUITABLE FOR TAKING THE  
LOADING FROM THE  
PROPOSED PLANTER SYSTEM.

**TYPE A-D UP TO 600mm (23.6 in) HIGH**  
N.T.S.

**TYPE E-G UP TO 900mm (35.4 in) HIGH**  
N.T.S.

**TYPE H-J UP TO 1100mm (43.3 in) HIGH**  
N.T.S.

**GENERAL CONSTRUCTION NOTES**

1. THIS DRAWING IS TO BE READ IN CONJUNCTION WITH ALL OTHER DRAWINGS, ENGINEER'S AND ARCHITECT'S DRAWINGS AND SPECIFICATIONS.
2. DO NOT SCALE FROM THIS DRAWING, USE FIGURES DIRECTLY FROM THE DRAWINGS.
3. ALL DIMENSIONS TO BE CONFIRMED BY THE ARCHITECT FOR SITE SETTING OUT.
4. FOR SITE SETTING OUT REFER TO THE ARCHITECT'S DRAWINGS.
5. ALL STEELWORK TO BE GRADE S355 U.N.O.

**CDM REGULATIONS 2015 RESIDUAL HAZARDS**

**RESIDUAL HAZARDS IDENTIFIED**

**CONSTRUCTION**

1. THE INSTALLATION OF THE PLANTER SYSTEM EXISTING STRUCTURES IS SUBJECT TO THE LANDLORDS ENGINEERS RECOMMENDED LOADINGS ON THE EXISTING STRUCTURE BELOW.

2. RISK OF INSTABILITY/TIPPING OF PLANTERS DURING CONSTRUCTION. CONTRACTORS MUST TAKE ALL FINES AND TIES PRIOR TO LOADING OF PLANTER SYSTEM WITH SOIL CONSIDERING THE INCOMPLETE STAGE OF PLANTER.

**FUTURE DEMOLITION**

AND SIGNIFICANT RESIDUAL HAZARDS BEYOND THOSE KNOWN TO AN UNPREDICTED CONTRACTOR

**NOTES**

THIS REGISTER IS A NON-EXHAUSTIVE LIST OF RESIDUAL HAZARDS RELATING TO THE WORKS SHOWN ON THE DRAWING THAT HAVE BEEN IDENTIFIED BY THE CONTRACTOR.

IT IS ASSUMED THAT ALL WORKS WILL BE CARRIED OUT BY A CONTRACTOR WITH APPROPRIATE ORGANISATIONAL CAPABILITY AND THAT THE CONTRACTOR IS A MEMBER OF THE APPROPRIATE TRADE BODY.

**abstract consulting**  
Structural & Civil Engineers  
T: 01733838030 E: info@abstract-consult.com www.abstract-consult.com

**RAAFT**  
Project  
PLANTERLINE 3mm STEEL  
PLANTER WALL SYSTEM

**Drawing Title**  
PLANTERS ON RAISED ACCESS  
FLOOR GENERAL ARRANGEMENT  
PLANS, SECTIONS & DETAILS

**Status** S0-INITIAL STATUS

**Scale** As indicated @A1 Proj.No. AC23163

**Drawing Ref.** AC23163-ABS-ZZ-ZZ-DR-S-3001 **Revision** P03

**Copyright** abstract consulting

# PLANTERLINE STRAIGHT

## INSTALLATION GUIDE



**SECTION THROUGH FREESTANDING PLANTER**  
1:10

**TIE DETAIL**  
N.T.S

**FREESTANDING PLANTER WITH TIES**  
N.T.S

**FREESTANDING PLANTER SIZES**

REF.	HEIGHT (Y) in mm	FIN WIDTH (X) in mm	BASE WIDTH (Z) in mm	TIE REQ.	MAX. SPACING (c/c) in mm
A	300 (11.8 in)	100 (3.9 in)	160 (6.3 in)	NO	800 (31.5 in)
B	400 (15.8 in)	100 (3.9 in)	200 (7.9 in)	NO	800 (31.5 in)
C	500 (19.7 in)	100 (3.9 in)	200 (7.9 in)	YES	800 (31.5 in)
D	600 (23.6 in)	100 (3.9 in)	200 (7.9 in)	YES	800 (31.5 in)
E	700 (27.6 in)	200 (7.9 in)	200 (7.9 in)	YES	800 (31.5 in)
F	800 (31.5 in)	200 (7.9 in)	200 (7.9 in)	YES	800 (31.5 in)
G	900 (35.4 in)	200 (7.9 in)	200 (7.9 in)	YES	800 (31.5 in)
H	1000 (39.4 in)	250 (9.8 in)	250 (9.8 in)	YES	600 (23.6 in)
F	1100 (43.3 in)	250 (9.8 in)	250 (9.8 in)	YES	600 (23.6 in)

PLANTERS TO BE FORMED FROM MIN. 3mm THICK FOLDED PLATE. WHERE WELDED JOINTS ARE REQUIRED USE MIN 5mm CFW.

**DESIGN CRITERIA:**  
THIS PLANTER SYSTEM HAS BEEN DESIGNED TO ACCOMMODATE SOIL LOADINGS IN ACCORDANCE WITH BS 8006-1. THE FOLLOWING CRITERIA:  
MAX SURCHARGE LOADINGS ONTO PLANTER = 0.75N/mm²  
ASSUMED WATER TABLE LEVEL = HEIGHT OF PLANTER  
TOP SOIL BULK DENSITY = 18kN/m³  
AND A COMPACTED DENSITY = 15.5kN/m³  
PLANTER STEELWORK GRADE = MIN. 3mm THICK GRADE S275 CORTen STEEL.  
MAX CENTERS OF FIN SPACES CALCULATED BY ABSTRACT TO BE 12m OR LESS  
CENTERS OF FINS PROVIDED IN THE ABOVE TABLE ARE TO BE ADOTTED WHICH ARE BASED UPON MANUFACTURER RECOMMENDATION FOLLOWING AS-BUILT TESTING.

**TYPICAL FREESTANDING PLANTER SECTION**  
1:5

**TYPE A-D UP TO 600mm (23.6 in) HIGH**  
N.T.S

**TYPE E-G UP TO 900mm (35.4 in) HIGH**  
N.T.S

**TYPE H-J UP TO 1100mm (43.3 in) HIGH**  
N.T.S

**PLANTERLINE 3mm STEEL PLANTER WALL SYSTEM**

**Drawing Title**

**FREESTANDING PLANTERS GENERAL ARRANGEMENT PLANS, SECTIONS & DETAILS**

**Status** S0-INITIAL STATUS

**Scale** As indicated @A1 Proj.No. AC23163

**Drawing Ref.** AC23163-ABS-ZZ-ZZ-DR-S-3005 **Revision** P03

**Copyright** abstract consulting

**GEAR**

1. THIS DRAWING IS TO BE READ IN CONJUNCTION WITH ALL OTHER APPROPRIATE ENGINEERS AND ARCHITECTS DRAWINGS AND SPECIFICATIONS.

2. DO NOT SCALE FROM THIS DRAWING USE FIGURED DIMENSIONS.

3. ALL DIMENSIONS TO BE CONFIRMED BY THE ARCHITECTS DRAWINGS.

4. FOR SITE SETTING OUT REFER TO THE ARCHITECTS DRAWINGS.

5. ALL STEELWORK TO BE GRADE S355 UNO.

**GENERAL**

1. ALL WORK & MATERIALS TO COMPLY WITH THE RELEVANT BRITISH STANDARDS CODES OF PRACTICE AND THE BUILDING REGULATIONS.

2. THE CONTRACTOR SHALL ENSURE THAT ANY DETAIL INDICATED OR IMPLIED ON THIS DRAWING CANNOT BE ALTERED.

3. THE CONTRACTOR SHALL ENSURE THAT THE PLANTER SYSTEM IS SUITABLE FOR THE STAGES OF CONSTRUCTION AND DECONSTRUCTION.



**CDM REGULATIONS 2015 RESIDUAL HAZARDS**

**RESIDUAL HAZARDS IDENTIFIED**

1. THE INSTALLATION OF THE PLANTER SYSTEM ON EXISTING STRUCTURES SUBJECT TO THE LANDLORDS ENGINEERS REVIEW OF THE PROPOSED LOADINGS ON THE FOUNDING STRUCTURE BELOW.

2. RISK OF INSTABILITY/TOPPLING OF PLANTERS DURING CONSTRUCTION AND DECONSTRUCTION OF PLANTERS AND TIES PRIOR TO LOADING OF PLANTER SYSTEM WITH SOIL. CONTRACTOR TO TAKE APPROPRIATE MEASURES FOR THE SAFE STORAGE OF UN-SUIT / INCOMPLETE PLANTERS.

**FUTURE DEMOLITION**

A NON-SIGNIFICANT RESIDUAL HAZARD BEYOND THOSE KNOWN TO AN EXPERIENCED CONTRACTOR.

**NOTES**

THIS DRAWING IS A NON-EXHAUSTIVE LIST OF RESIDUAL HAZARDS RELATING TO THE WORKS SHOWN ON THIS DRAWING THAT HAVE BEEN IDENTIFIED BY THE CONTRACTOR.

IT IS ASSUMED THAT ALL WORKS WILL BE CARRIED OUT BY A CONTRACTOR WITH THE APPROPRIATE SKILL, EXPERIENCE AND COMPETENCE FOR THE WORKS. THE CONTRACTOR IS RESPONSIBLE FOR ASSESSING THE HAZARDS FOR AN ORGANISATION, THE ORGANISATIONAL CAPABILITY NECESSARY TO FULLY ASSESS HAZARDS.



**abstract**  
consulting  
Structural & Civil Engineers  
T: 01733830030 E: info@abstract-consult.com www.abstract-consult.com

**R RAAFT**  
Project  
PLANTERLINE 3mm STEEL PLANTER WALL SYSTEM  
Drawing Title  
FREESTANDING PLANTERS GENERAL ARRANGEMENT PLANS, SECTIONS & DETAILS  
Status S0-INITIAL STATUS  
Scale As indicated @A1 Proj.No. AC23163  
Drawing Ref. AC23163-ABS-ZZ-ZZ-DR-S-3005 Revision P03  
Copyright abstract consulting

# PLANTERLINE STRAIGHT




## INSTALLATION GUIDE

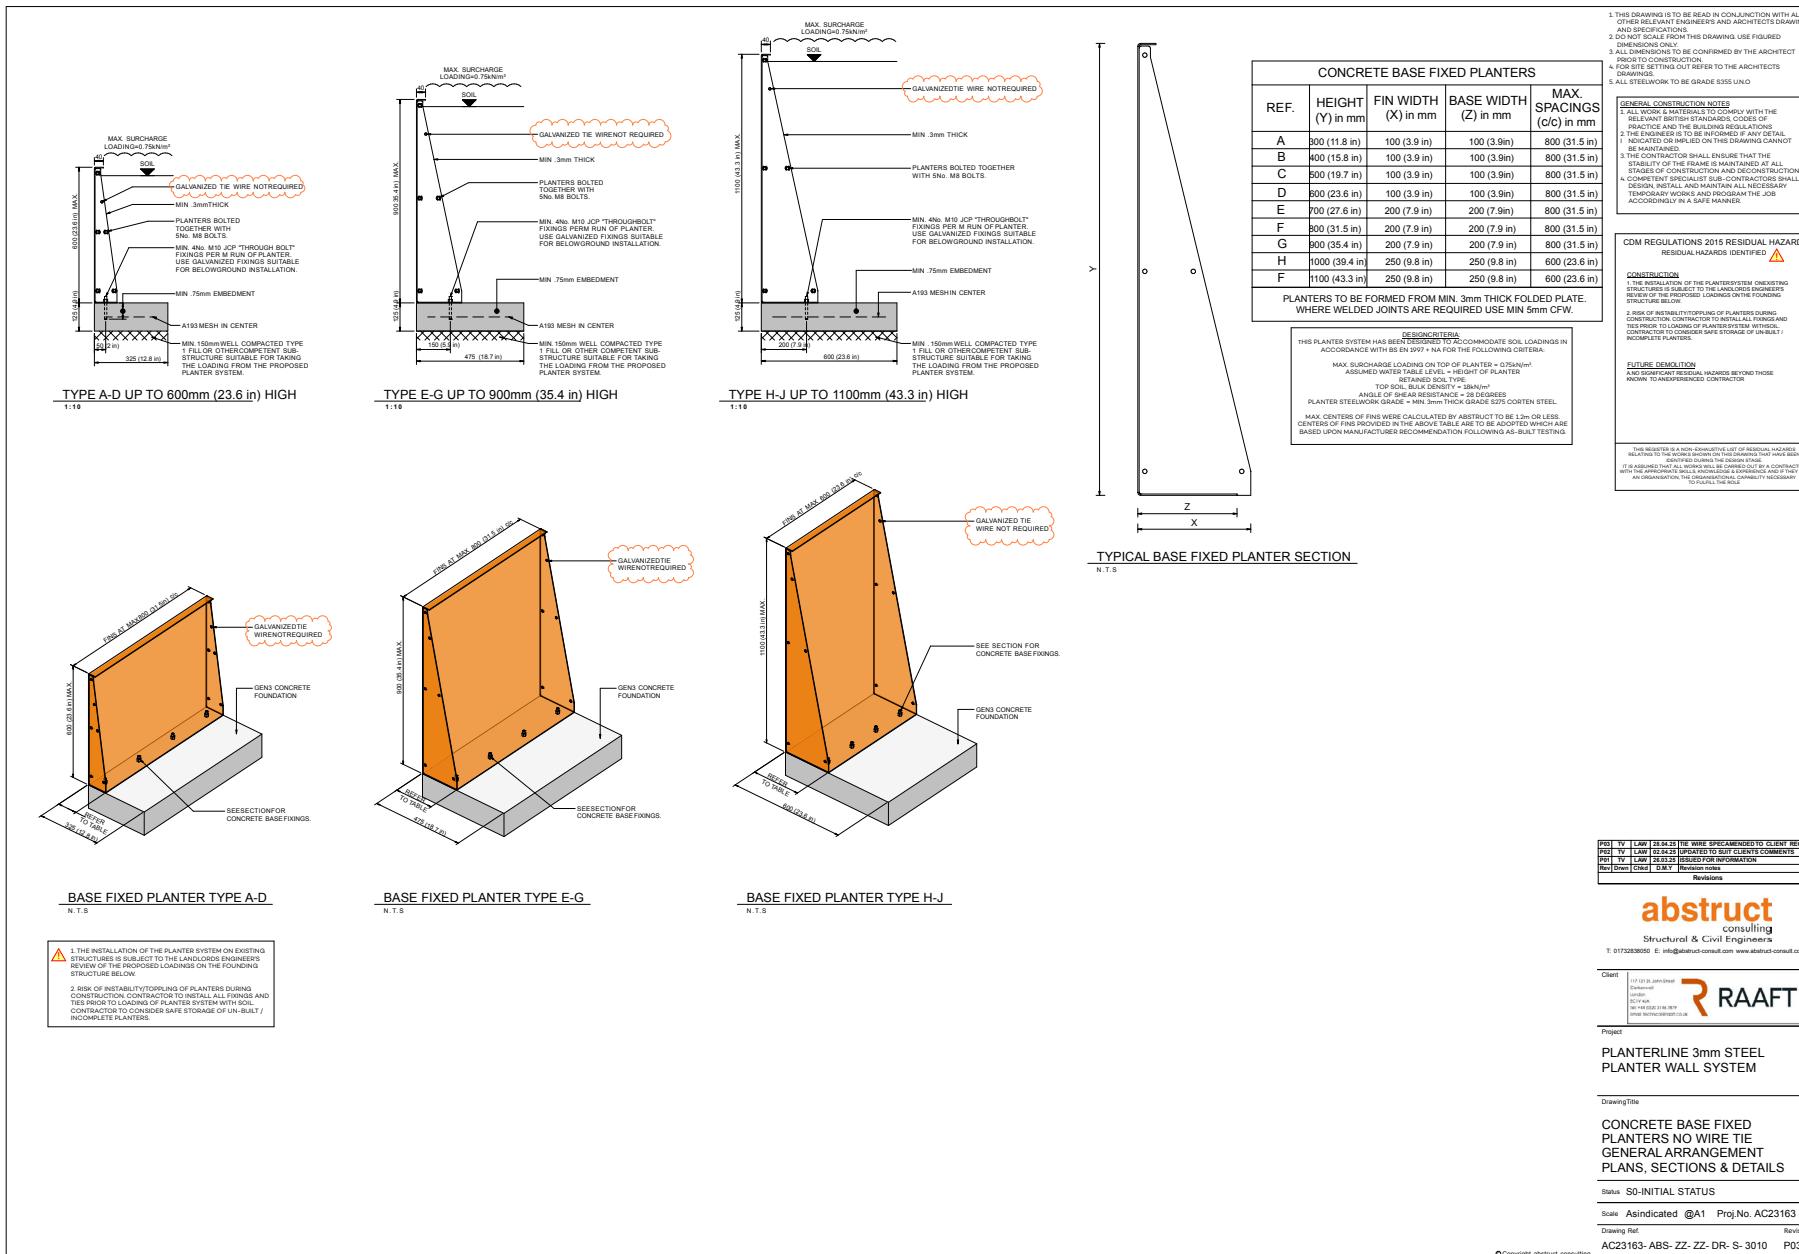


## Strengthening options

All planters higher than 600mm (23.6 in).

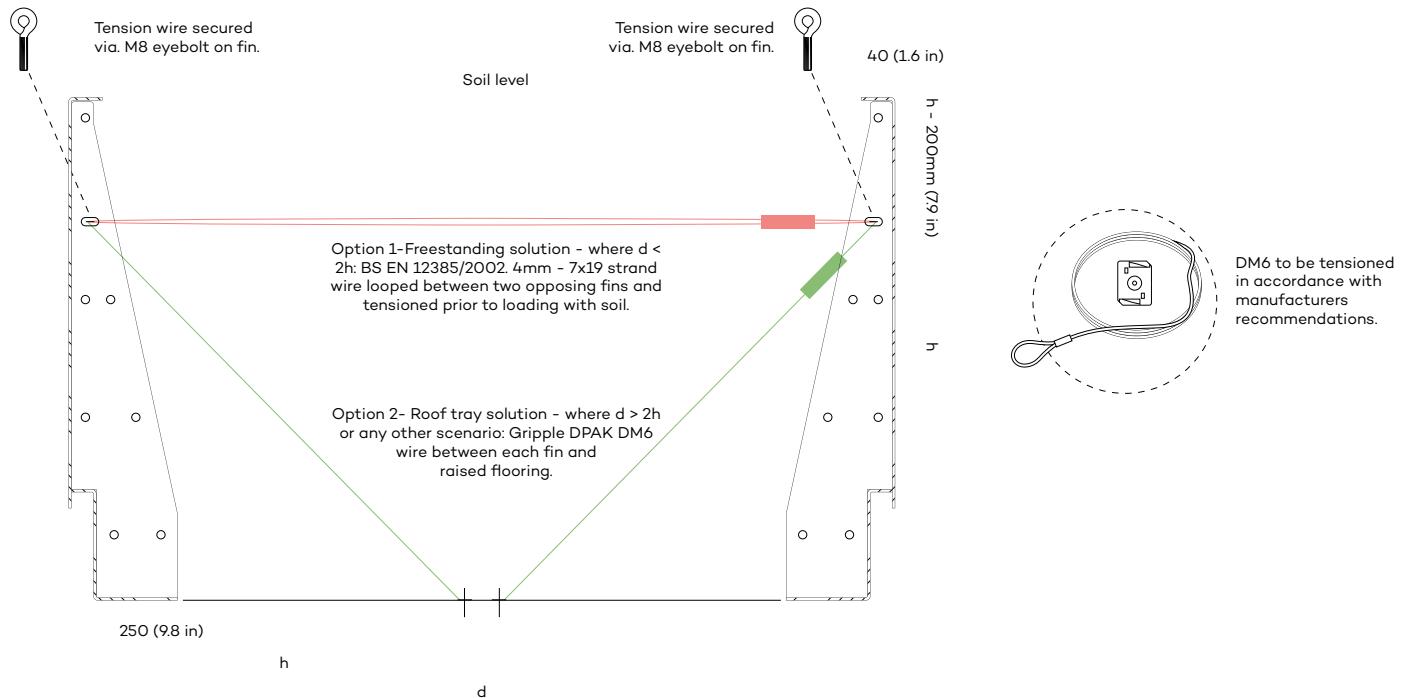

**Plan view of both bracing solutions (Freestanding and Rooftray)**

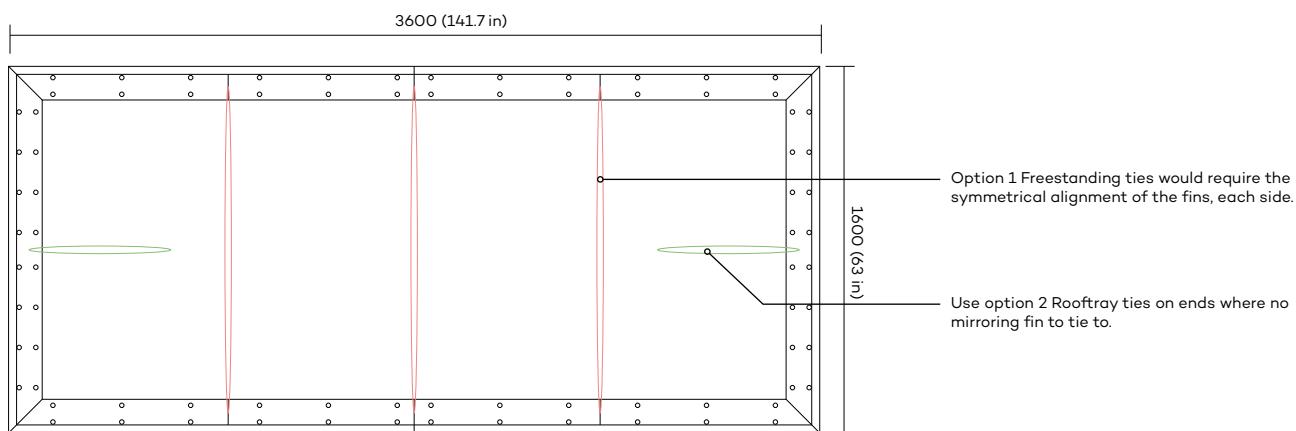

**Find out more or request a sample**

Email [hello@raafsystems.com](mailto:hello@raafsystems.com) or visit [raafsystems.com](http://raafsystems.com)



## Accessories



### Lockable cabinet

Used within the planter walls (welded in place) for access or storage of weatherproof products/items. It can accommodate P67 rated power sockets and lighting boxes for external lighting.

For added security, a panel lock, complete with a key, prevents unauthorized access.

The cabinet comes in the following sizes:


500(H) x 600 x 200 mm (19.7 x 23.6 x 7.9 in)

400(H) x 500 x 200 mm (15.8 x 19.7 x 7.9 in)

250(H) x 300 x 200 mm (9.8 x 11.8 x 7.9 in)

### Lighting detail

Illuminate your planters with our lighting options. Feel free to contact any member of our team if you're interested in enhancing your planters with a touch of light.

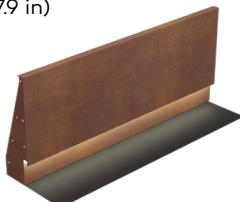

## Installation Information

The installation is then completed by covering the extent of the floor structure panels, which pass beyond the planter perimeter with porcelain tiles. To secure the planter into concrete, we advise from past planter installations, the creation of a 300mm (11.8 in) wide by 150mm (5.9 in) deep concrete race around the planter's perimeter. M10 through bolts (supplied by Raaft®) are used for fixing down the planter into the concrete. Bracing becomes necessary for planters exceeding a height of 600mm. This is to account for potential loads imposed by soil and any additional stresses within a terrace environment. The recommended bracing solutions for Raaft® planters include tensioning wire or a metal strap spanning from one side to the other.

## Product finishes

**Corten A** is a type of weathering steel which was developed to remove the need for regular painting and rust-prevention maintenance.

**Note: Refer to the Corten guide for more information.**

This is achieved by the formation of a natural stable coating of dark brown oxidation across the metal's surface which acts as a barrier to the corrosive effects of rain, snow and other weather conditions. When delivered, the Corten will contain mill-scale which will remove over time prior to the natural stable coating of dark brown being achieved. The weathering process can take around 18 months.

**Powder coating** starts with shot-blasting of the steel which removes mill-scale, oxide dirt, oil and grease from the substrate; followed by a 7-stage zinc phosphate pre-treatment process to prepare the surface. The product then receives the polyester powder coating to the requested color. Polyester has excellent exterior durability and color retention. Numerous color options from world leading powder manufacturers are available.

**Choose from these finishes:**



Corten

PPC

## Find out more or request a sample

Email [hello@raafsystems.com](mailto:hello@raafsystems.com) or visit [raafsystems.com](http://raafsystems.com)



## Sustainability

Planterline is crafted from two material options: Untreated steel or Stainless Steel, and it boasts 100% recyclability. Consequently, Planterline stands out for its outstanding whole-life cost, as it is marketed with recycling in mind rather than incurring disposal costs. The primary component in steel production is iron, ranking second only to aluminum in terms of its natural abundance in the earth's crust. Considering current extraction rates, there exists a sufficient iron supply to sustain production for well over 1000 years.

### Steel

Mild steel is widely recognized as a sustainable material for several compelling reasons:

#### 1. Longevity and Durability

Mild steel boasts exceptional longevity and durability. When compared to less robust materials, it provides extended service over many years. For instance, while other materials may require annual replacement, using mild steel every five years significantly reduces the environmental impact, as it necessitates less energy for continuous replacement.

#### 2. Versatility

Mild steel offers high versatility in terms of shapes and sizes during production. Its malleability allows it to take on various forms, making it highly adaptable and suitable for a wide range of applications.

#### 3. Recyclability

One of the most significant sustainable advantages of mild steel is its recyclability. While the percentage of recyclable content may vary by type, it typically contains a high percentage of recyclable material. This aligns seamlessly with its versatility, as any surplus steel from manufacturing processes can be repurposed for smaller products or recycled, making it an environmentally friendly metal choice.

#### 4. Absence of Harmful Chemicals

Unlike some other metals, the production of mild steel does not involve the release of harmful chemicals or toxins. This characteristic contributes to its eco-friendliness.

## Product maintenance

### Steel

For the Planterline, the steel is powder coated. This will require little/no maintenance as there won't be any interaction between this part of the product and the user.

## Fire protection

Planterline planters are made using Corten A, or Mild Steel, neither of which burn nor pose a fire hazard.

Corten A is high performance materials that display excellent resistance to atmospheric corrosion when compared to other steels, making them exceptionally suitable for custom planter applications.

## Protective equipment

We recommend that PPE (Personal Protective Equipment) is used when installing the Planterline:

- a) Wear sturdy safety boots/shoes to protect your feet.
- b) Protective eye wear such as safety glasses.
- c) Strong gloves to protect your hands.
- d) When using loud cutting equipment, wear ear plugs or hearing protection .

## General construction notes

- All folding tolerances are  $\pm 1.2\text{mm}$  with an angle variation of  $\pm 1^\circ$
- All rolling tolerances  $\pm 8\text{mm}$
- All fabricated and welded components are manufactured to a tolerance of  $\pm 2\text{mm}$
- Tolerance of  $\pm 5\text{mm}$  across a diagonal measurement
- Where powder coated components are applicable, they are completed to the following specification:

Pre-treatment - shot blast SA 25

Primer - Zinc-rich primer with a minimum of  $60\mu$

Top coat - Final top coat to be a minimum of  $60\mu$

- All Corten finishes are supplied as untreated/unweathered

## Find out more or request a sample

Email [hello@raafsystems.com](mailto:hello@raafsystems.com) or visit [raafsystems.com](http://raafsystems.com)



## Storage and handling

The product is securely packed and sealed to ensure no movement of the product in transit. Depending on the size / weight of the consignment this may be palletized.

While there is no specific weight restriction on what is or is not safe to lift in manual handling, an assessment of the health and safety risks should be undertaken and measures taken to reduce the risk of injury so far as reasonably practicable.

The following guidelines may be useful:

- a) Each person should be fully trained in manual handling techniques.**
- b) The use of handling aids such as a cart, forklift, pallet truck or conveyor should be used if moving large volumes of cartons.**
- c) Break up large consignments into more manageable loads.**
- d) Ensure that the product is stored at a reasonable height, so avoiding the lifting of cartons from floor level or above shoulder height.**



### Manual handling

Refer to bills of materials for weights.

## General construction notes

- All folding tolerances are  $\pm 1.2\text{mm}$  with an angle variation of  $\pm 1^\circ$
- All rolling tolerances  $\pm 8\text{mm}$
- All fabricated and welded components are manufactured to a tolerance of  $\pm 2\text{mm}$
- Tolerance of  $\pm 5\text{mm}$  across a diagonal measurement
- Where powder coated components are applicable, they are completed to the following specification:  
Pre-treatment - shot blast SA 25  
Primer - Zinc-rich primer with a minimum of  $60\mu$   
Top coat - Final top coat to be a minimum of  $60\mu$
- All Corten finishes are supplied as untreated/unweathered

## Find out more or request a sample

Email [hello@raafsystems.com](mailto:hello@raafsystems.com) or visit [raafsystems.com](http://raafsystems.com)